


PLACAS GEORREFERENCIADAS					
PLACA	LATITUD	LONGITUD	NORTE	ESTE	COTA
GPS 1-UNW	4°04'33.52268"	73°35'04.84078"	942460.424	1054721.283	381.497
GPS 2-UNW	4°04'30.71101"	73°35'07.37856"	942464.078	1054627.614	382.600

DELTA'S TOPOGRAFICOS			
PLACA	NORTE	ESTE	COTA
SM1	942410.234	1054749.383	381.785
SM2	942447.330	1054896.903	381.204
SM3	942330.528	1054774.078	382.205
SM5	942648.824	1055043.038	380.042
SM6	942858.582	1055088.160	379.533
SM7	942335.218	1054791.287	382.059
SM8	943141.545	1054833.718	382.339
SM9	942344.829	1054695.342	382.519
SM10	942333.030	1054652.199	382.825



PROYECTO
LEVANTAMIENTO TOPOGRAFICO ALCANTARILLADO RESIDUAL UNIVERSIDAD DE LOS LLANOS VILLAVICENCIO META

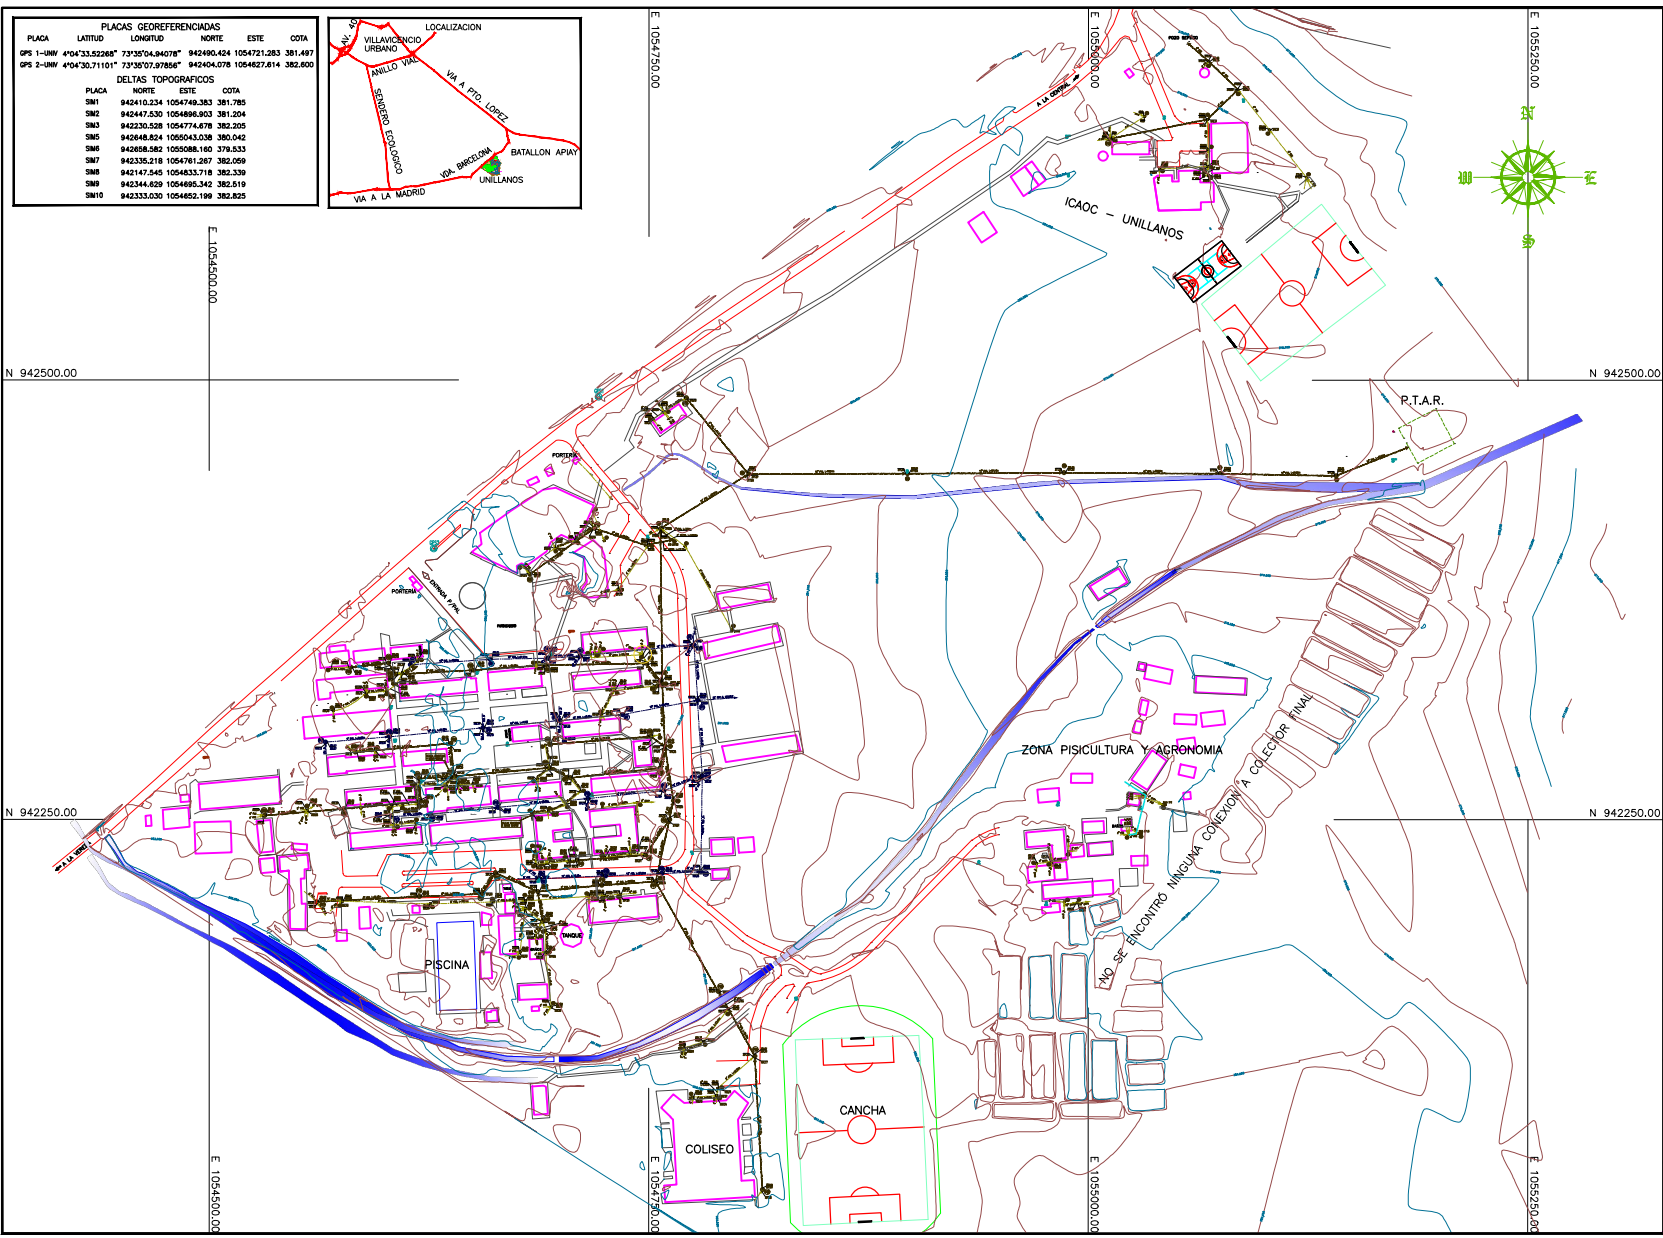

CONVENCIONES

[Pink outline]	CONSTRUCCION
[Red line]	VIA
[Circle with dot]	POZO A.N.
[Square with dot]	CANA A.N.
[Thick blue line]	LINEA A.N. PRINCIPAL
[Thin blue line]	LINEA A.N. SECUNDARIA
[Thin blue line]	POZO A.L.
[Thick blue line]	LINEA A.L. PRINCIPAL
[Blue square]	DELTA'S TOPOGRAFICOS

SISTEMA DE REFERENCIA

PROYECTO	UTM
ZONA	18Q
ESCALA	1:500

PROPIETARIO

INFORMACION PRELIM.

CEDEÑA CATASTRAL: SIN
 MAT. INMOBILIARIA: SIN

PROFESIONAL RESPONSABLE

TOP. MARCO SERAFIN REIBA CASTRO
 MAT. N° 01-2054 CRTPT

OBSERVACIONES

CONTENIDO

PLANTA ALCANTARILLADO RESIDUAL

Agosto 16 de 2018

ESCALA 1:1.500

ESCALA GRAFICA

