


PLACAS GEORREFERENCIADAS			
PLACA	LATITUD	LONGITUD	COTA
SP1	14°04'23.02288"	73°37'07.87800"	942460.078 1004871.283 381.487
SP2	14°04'20.71101"	73°37'07.87800"	942460.078 1004871.214 382.800
DELTA DE TOPOGRAFICOS			
PLACA	NORTE	ESTE	COTA
SB1	942410.234	100446.283	381.780
SB2	942410.230	100486.283	381.204
SB3	942320.028	100477.678	382.200
SB4	942384.824	100480.028	382.043
SB5	942388.082	100488.180	379.632
SB6	942358.178	100471.287	382.029
SB7	942147.245	100483.778	382.239
SB8	942344.828	100488.242	382.878
SB9	942320.020	100480.180	382.820

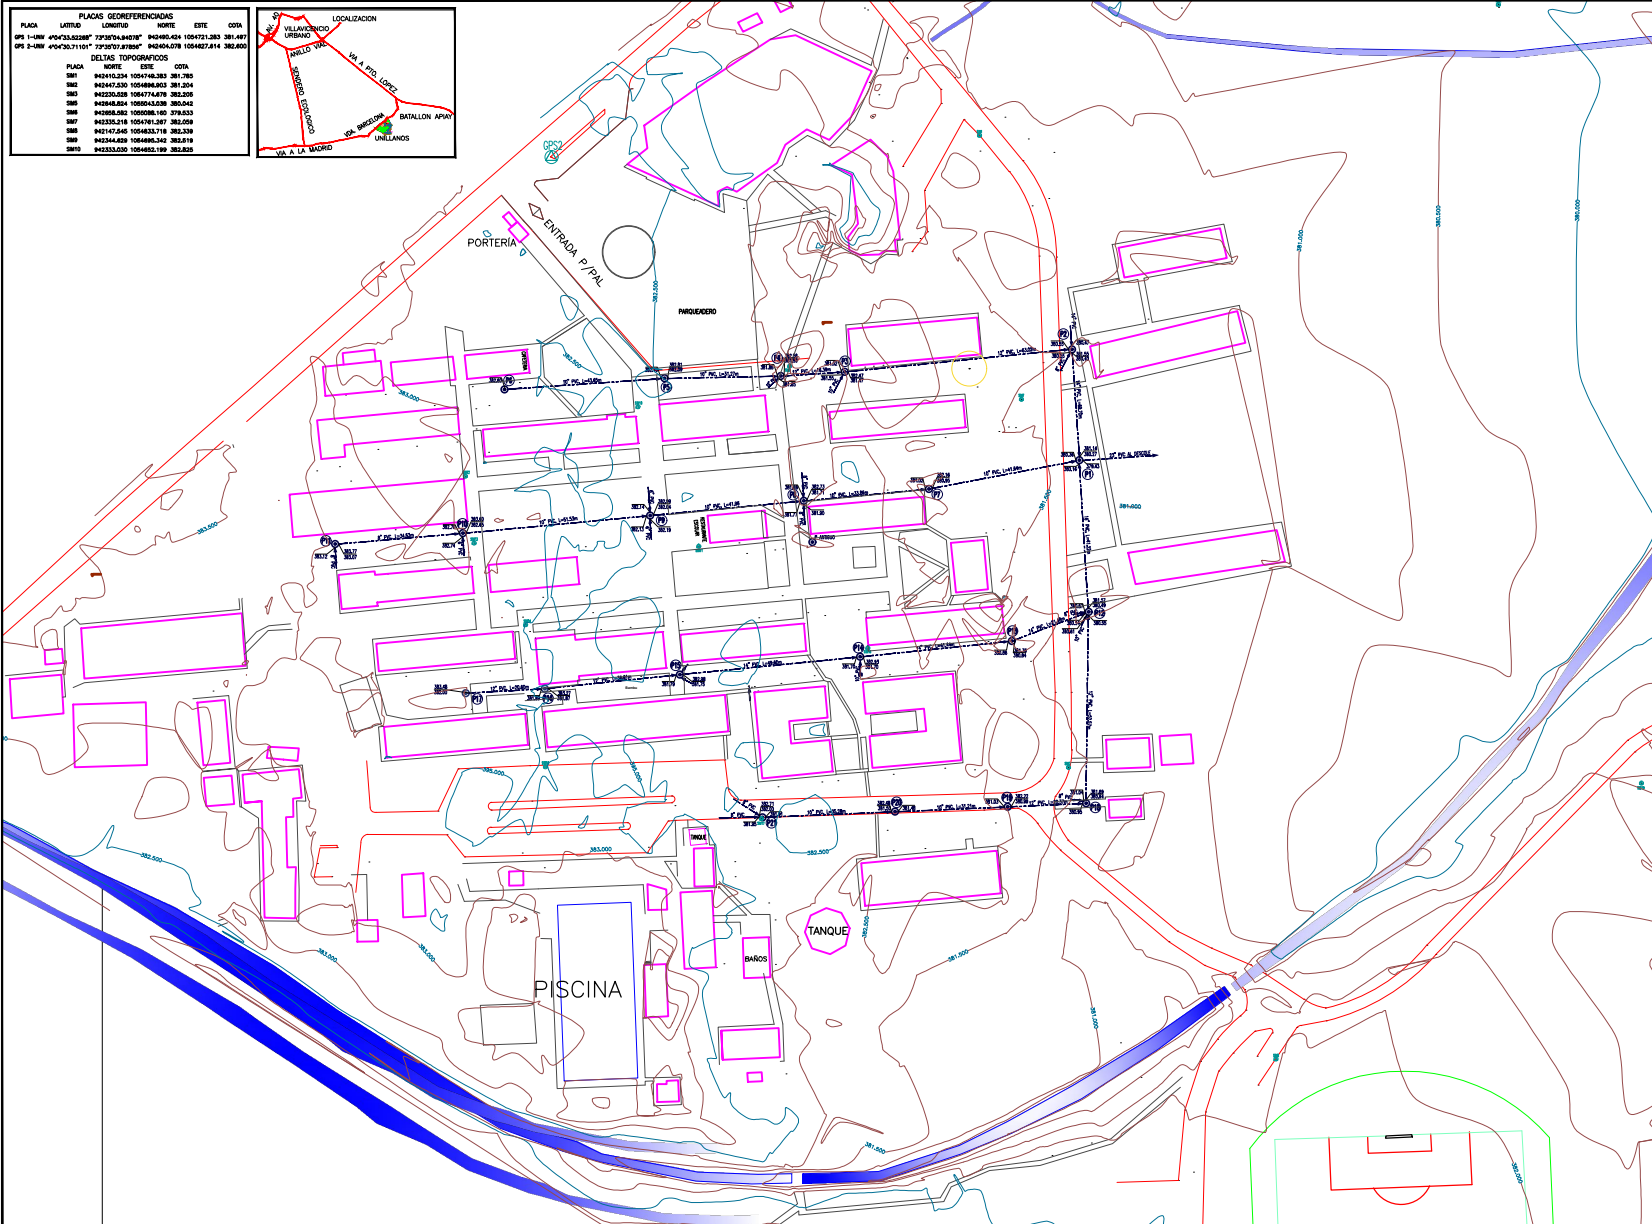

PROYECTO  
**LEVANTAMIENTO TOPOGRAFICO ALCANTARILLADO RESIDUAL UNIVERSIDAD DE LOS LLANOS VILLAVICENCIO META**



CONVENCIONES

[Pink outline]	CONSTRUCCION
[Red line]	VA
[Circle with dot]	POZO A.N.
[Square with dot]	CANA A.N.
[Thick blue line]	LINEA A.N. PRINCIPAL
[Thin blue line]	LINEA A.N. SECUNDARIA
[Circle with cross]	POZO A.L.
[Thick blue line]	LINEA A.L. PRINCIPAL
[Thin blue line]	DELTA TOPOGRAFICOS

ESTIMA DE REFERENCIA

PROPIEDAD

INFORMACION PRECISA

CEDELA CATASTRAL: SIN  
MAT. INMOBILIARIA: SIN

PROFESIONAL RESPONSABLE

TOP. MARCO SERAFIN REIBA CASTRO  
MAT. N° 01-2054 CRPT

OBSERVACIONES

CONTENIDO

PLANTA ALCANTARILLADO PLUVIAL

Agosto 16 de 2018

ESCALA 1:750

ESCALA GRAFICA

